LEGEND	
EML	ELECTROMAGNETIC LOCK
DC	DOOR CONTACT
EBG	EMERGENCY BREAK GLASS
DM20	SUB-CONTROLLER
R_out	CARD READER OUT
R_in	CARD READER IN
F_in	FACE RECOGNITION READER IN
CS40	MAIN CONTROLLER
RTE	REQUEST TO EXIT BUTTON
PSU	POWER SUPPLY UNIT
UPS	UNINTERRUPTIBLE POWER SUPPLY
	CAT6 UTP CABLE
	STP 18/4 (GAUGE 18, 4 CORE)
	TFW 18/2 (GAUGE 18, 4 CORE)
RIN	READER IN
ROUT	READER OUT
BIN	BIOMETRIC IN
BOUT	BIOMETRIC OUT
KS	KEYSWITCH
EDG	ELECTRONIC DROP BOLT
SS	STROBE AND SIREN
PB	PIEZO BUZZER

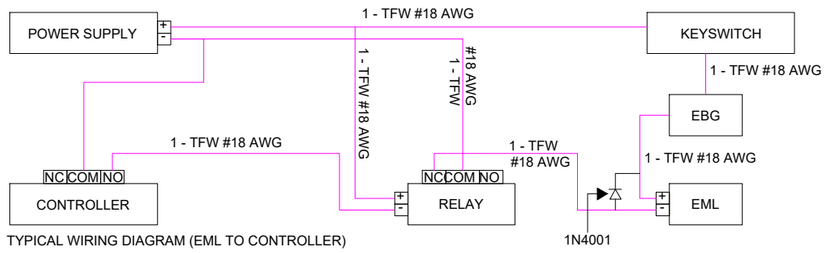

TYPICAL WIRING DIAGRAM (EML TO CONTROLLER)

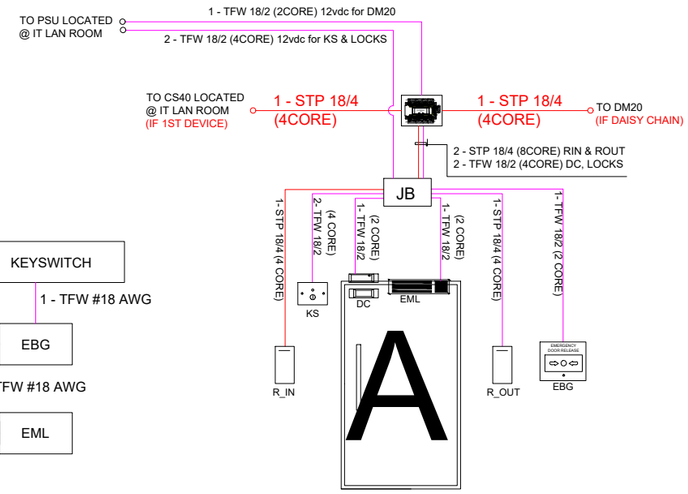

READER IN & READER OUT
(SINGLE LEAF DOOR)

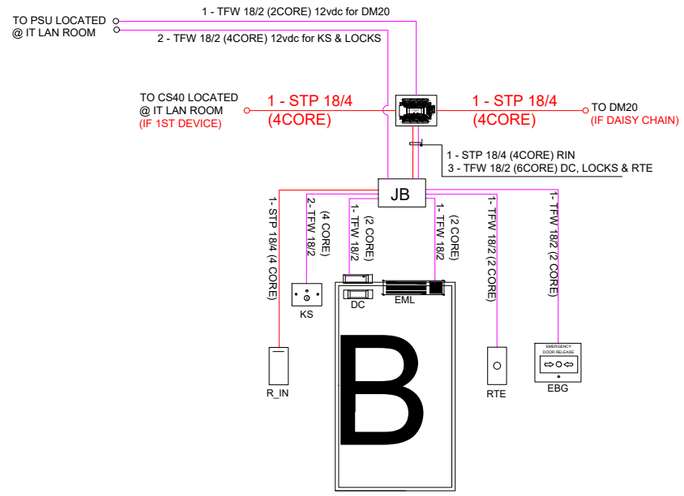

READER IN & RTE OUT
(SINGLE LEAF DOOR)

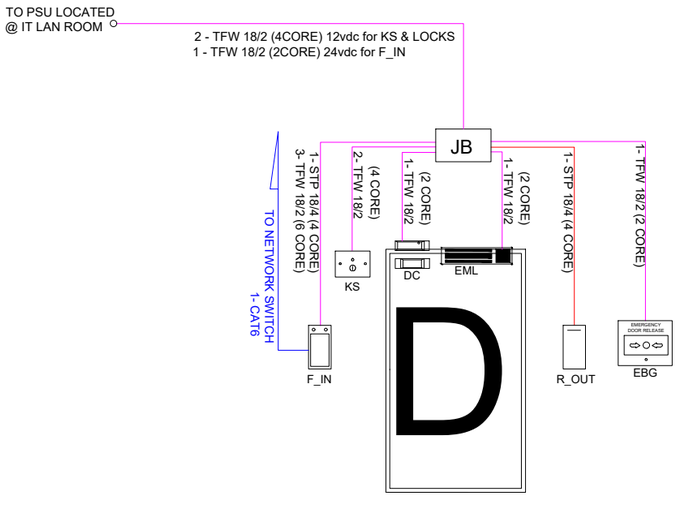

FACE IN & READER OUT
(SINGLE LEAF DOOR)

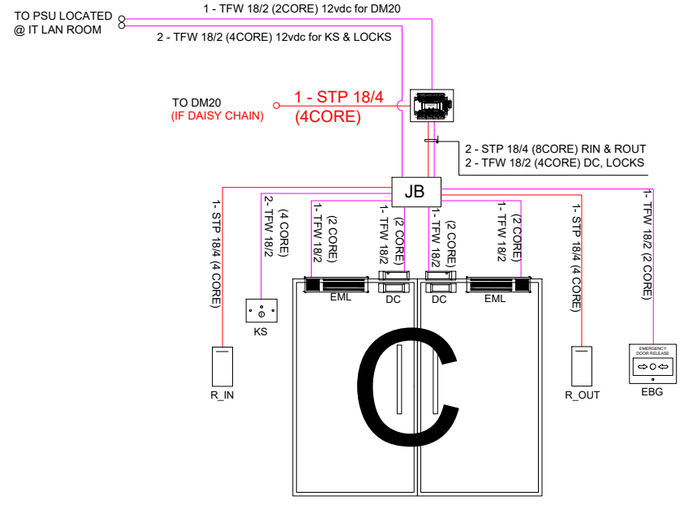

READER IN & READER OUT
(DOUBLE LEAF DOOR)

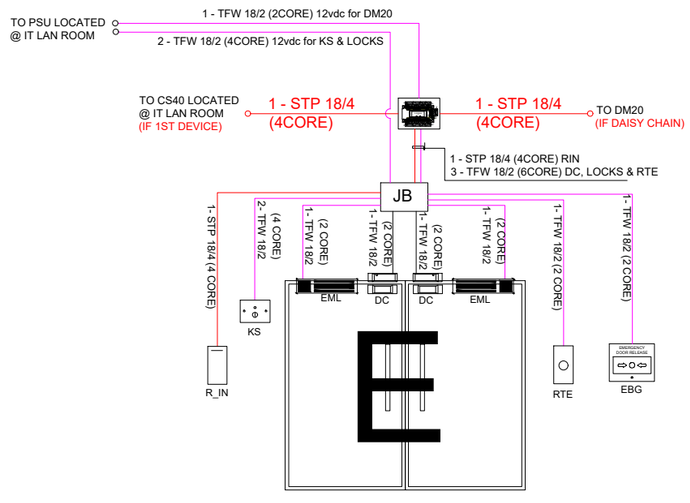

READER IN & RTE OUT
(DOUBLE LEAF DOOR)

1 ASBUILT
PANASIATIC BUILDING 2

	DESIGNED AND SUBMIITED:	APPROVED BY:	PROJECT OWNER:		PROJECT & LOCATION:	SHEET CONTENTS:	SET NO.:	SHEET NO.:
nexus technologies, inc.	Robinson TAgasa ROBINSON SB. TAGASA PROJECT MANAGER	DIONICIO RAMOS PANASIATIC MANAGER, ENGINEERING AND AUXILIARY SERVICES	MS. SIONY HIJARA-FERRARIS		PANASIATIC SOLUTIONS PANASIATIC CALL CENTER INC.	BLOW UP SLD DOOR ACCESS SYSTEM SUPREMA		1

LEGEND	
EML	ELECTROMAGNETIC LOCK
DC	DOOR CONTACT
EBG	EMERGENCY BREAK GLASS
DM20	SUB-CONTROLLER
R_out	CARD READER OUT
R_in	CARD READER IN
F_in	FACE RECOGNITION READER IN
CS40	MAIN CONTROLLER
RTE	REQUEST TO EXIT BUTTON
PSU	POWER SUPPLY UNIT
UPS	UNINTERRUPTIBLE POWER SUPPLY
	CAT6 UTP CABLE
	STP 18/4 (GAUGE 18, 4 CORE)
	TFW 18/2 (GAUGE 18, 4 CORE)
RIN	READER IN
ROUT	READER OUT
BIN	BIOMETRIC IN
BOUT	BIOMETRIC OUT
KS	KEYSWITCH
EDG	ELECTRONIC DROP BOLT
SS	STROBE AND SIREN
PB	PIEZO BUZZER

NOTE: DM20 (Sub Controller) CAN ONLY ACCOMMODATE TWO(2) READERS.

SHARING OF DM20 SUB-CONTROLLER READER IN AND RTE OUT (SINGLE LEAF DOOR)

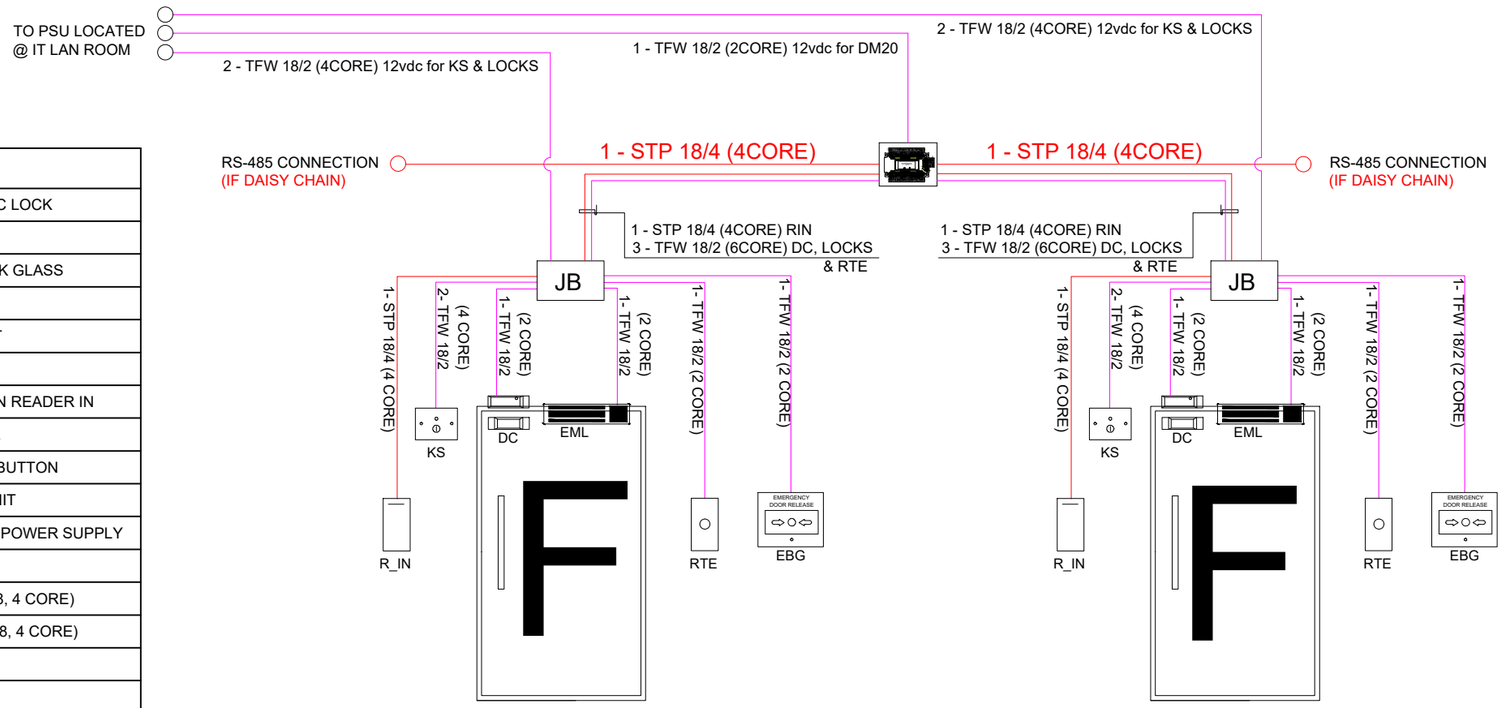

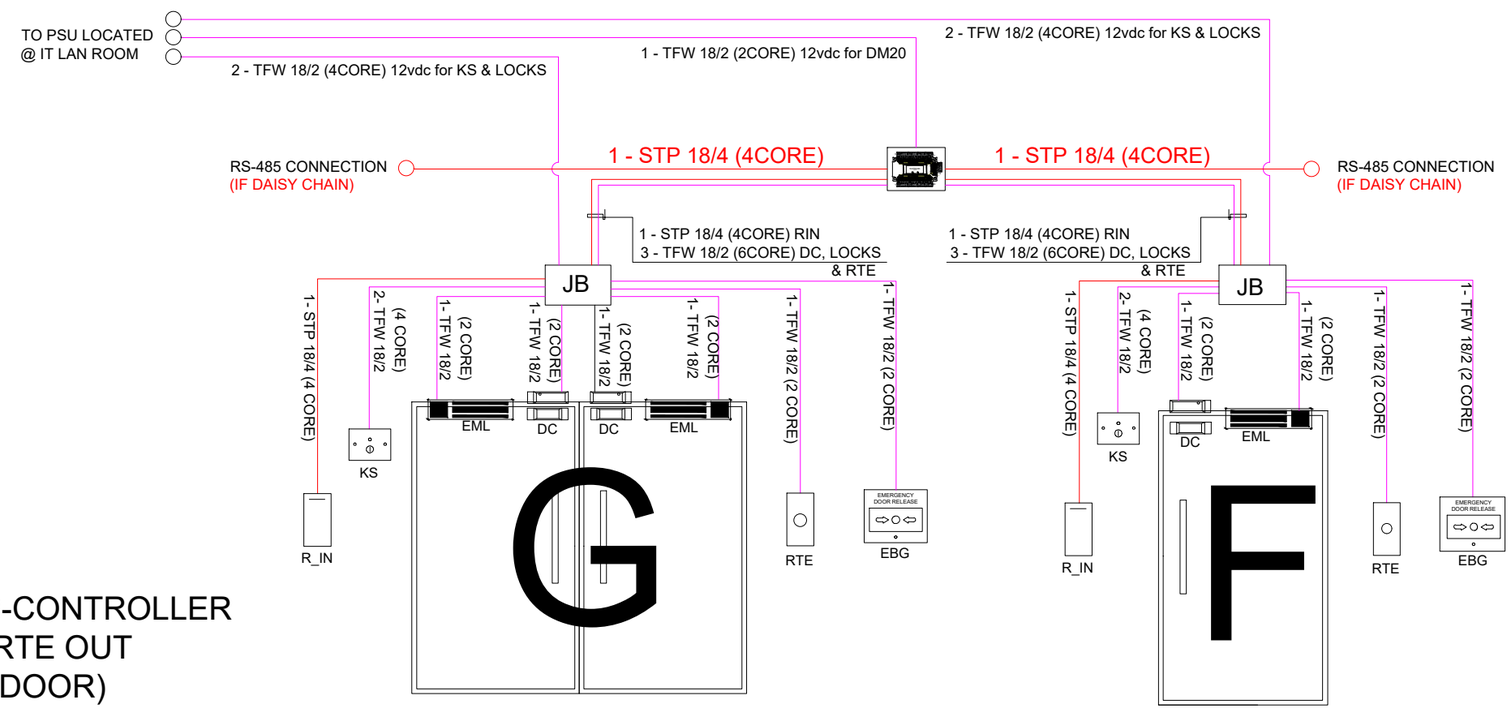

SHARING OF DM20 SUB-CONTROLLER READER IN AND RTE OUT (DOUBLE LEAF DOOR)

1 ASBUILT
PANASIATIC BUILDING 1

nexus technologies, inc.	DESIGNED AND SUBMITTED:	APPROVED BY:	PROJECT OWNER:		PROJECT & LOCATION:	SHEET CONTENTS:	SET NO.:	SHEET NO.:
	ROBINSON SB. TAGASA PROJECT MANAGER	DIONICIO RAMOS PANASIATIC MANAGER, ENGINEERING AND AUXILIARY SERVICES	MS. SIONY HIJARA-FERRARIS		PANASIATIC SOLUTIONS PANASIATIC CALL CENTER INC.	BLOW UP SLD DOOR ACCESS SYSTEM SUPREMA		2

LEGEND	
EML	ELECTROMAGNETIC LOCK
DC	DOOR CONTACT
EBG	EMERGENCY BREAK GLASS
DM20	SUB-CONTROLLER
R_out	CARD READER OUT
R_in	CARD READER IN
F_in	FACE RECOGNITION READER IN
CS40	MAIN CONTROLLER
RTE	REQUEST TO EXIT BUTTON
PSU	POWER SUPPLY UNIT
UPS	UNINTERRUPTIBLE POWER SUPPLY
	CAT6 UTP CABLE
	STP 18/4 (GAUGE 18, 4 CORE)
	TFW 18/2 (GAUGE 18, 4 CORE)
RIN	READER IN
ROUT	READER OUT
BIN	BIOMETRIC IN
BOUT	BIOMETRIC OUT
KS	KEYSWITCH
EDG	ELECTRONIC DROP BOLT
SS	STROBE AND SIREN
PB	PIEZO BUZZER

NOTE: DM20 (Sub Controller) CAN ONLY ACCOMMODATE TWO(2) READERS.

TWO DOORS READER IN AND READER OUT (SINGLE LEAF DOOR)

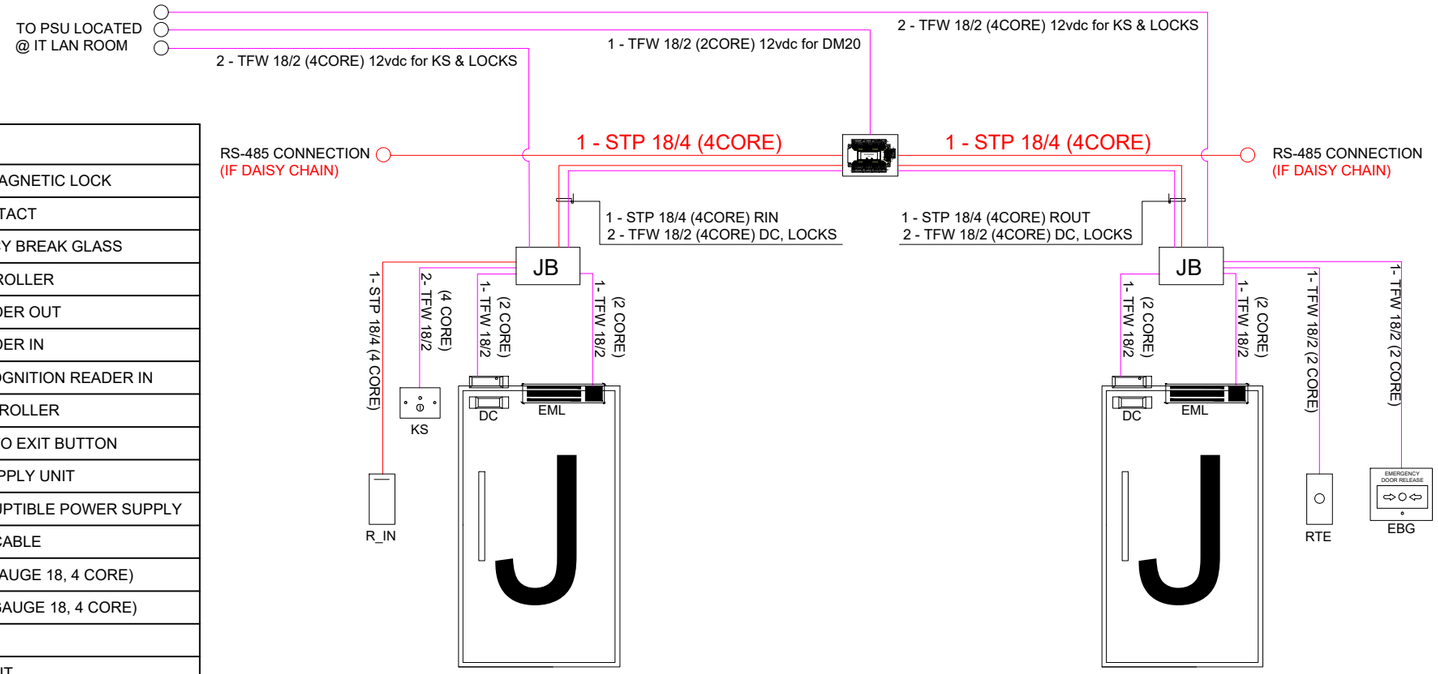

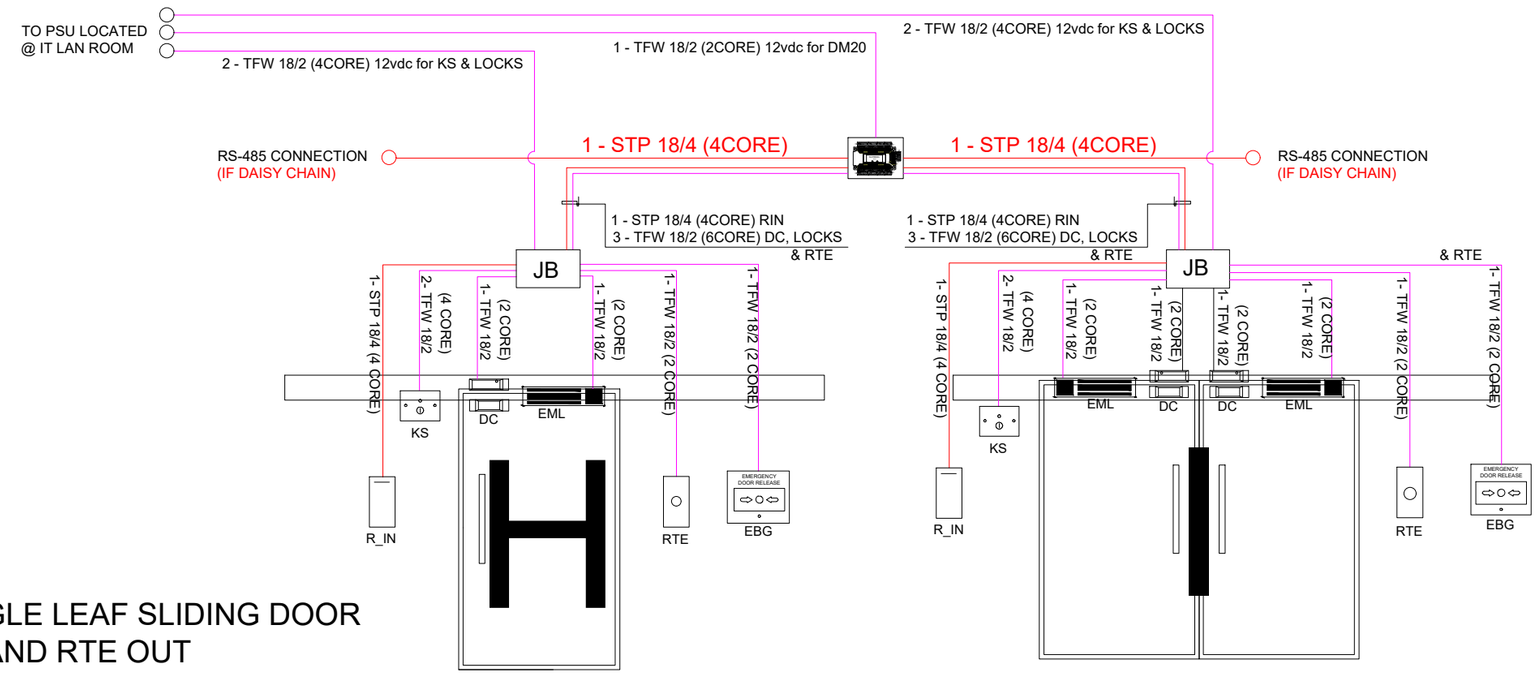

DOUBLE LEAF AND SINGLE LEAF SLIDING DOOR READER IN AND RTE OUT

1 ASBUILT
PANASIATIC BUILDING 1

DESIGNED AND SUBMIITED:	APPROVED BY:	PROJECT OWNER:		PROJECT & LOCATION:	SHEET CONTENTS:	SET NO.:	SHEET NO.:
Robinson TAgasa ROBINSON SB. TAGASA PROJECT MANAGER	DIONICIO RAMOS PANASIATIC MANAGER, ENGINEERING AND AUXILIARY SERVICES	MS. SIONY HIJARA-FERRARIS		PANASIATIC SOLUTIONS PANASIATIC CALL CENTER INC.	BLOW UP SLD DOOR ACCESS SYSTEM SUPREMA		3

LEGEND	
	DM20 POWER
	STP 18/4 (4 CORE)
	THHN #12
	CAT6 UTP CABLE

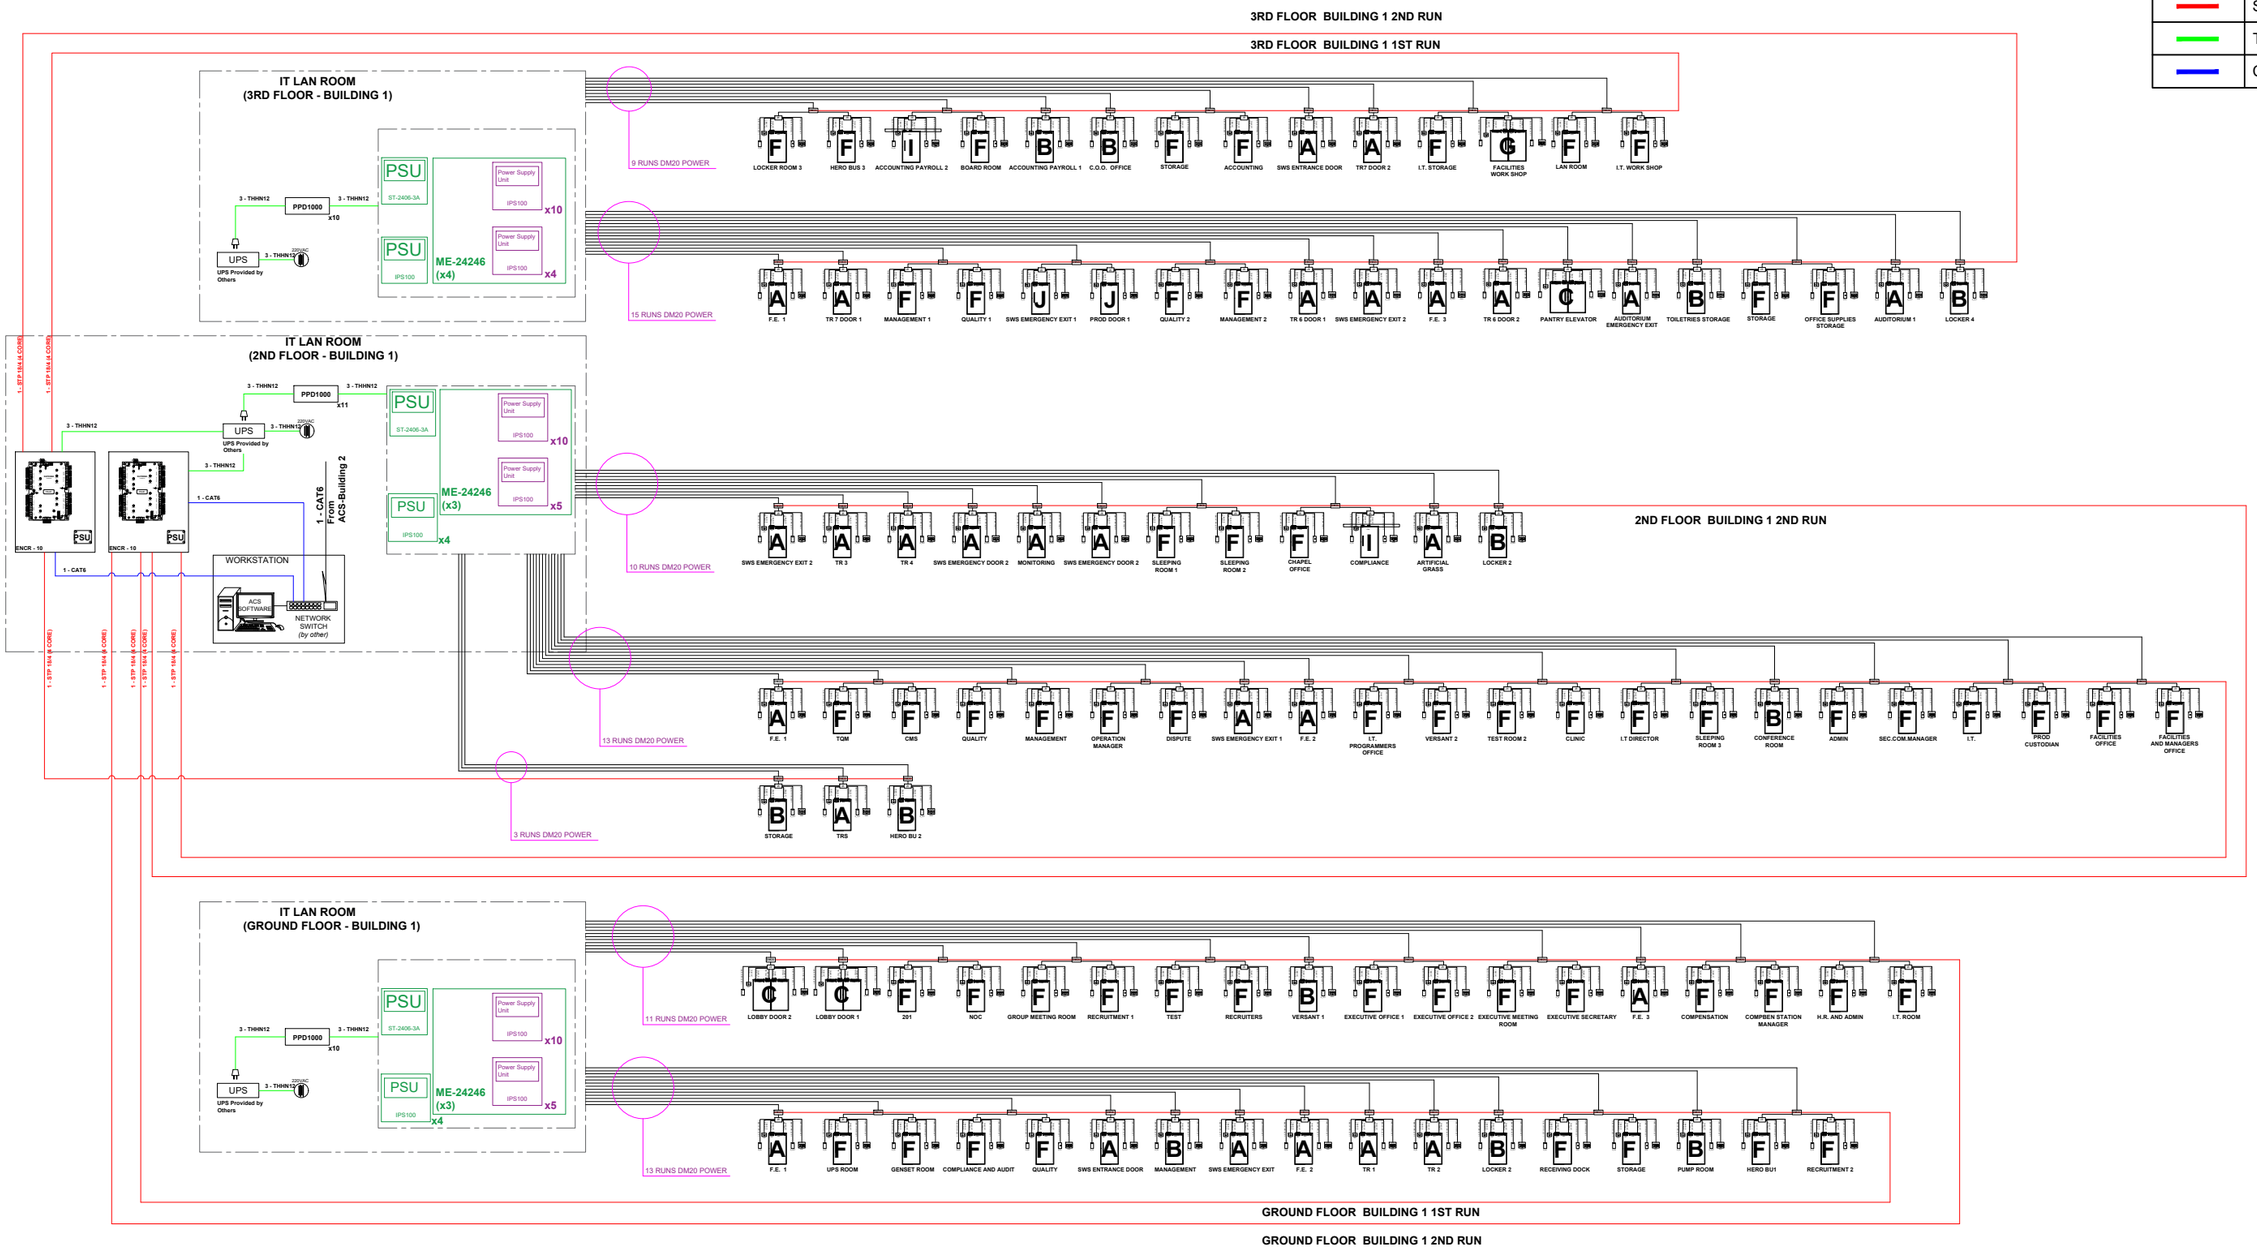

1 ASBUILT
PANASIATIC BUILDING 1

	DESIGNED AND SUBMIITED:	APPROVED BY:	PROJECT OWNER:		PROJECT & LOCATION:	SHEET CONTENTS:	SET NO.:	SHEET NO.:
nexus technologies, inc.	Robinson TAgasa ROBINSON SB. TAGASA PROJECT MANAGER	DIONICIO RAMOS PANASIATIC MANAGER, ENGINEERING AND AUXILIARY SERVICES	MS. SIONY HIJARA-FERRARIS		PANASIATIC SOLUTIONS PANASIATIC CALL CENTER INC.	DOOR ACCESS SINGLE LINE DIAGRAM		4

LEGEND	
	DM20 POWER
	STP 18/4 (4 CORE)
	THHN #12
	CAT6 UTP CABLE

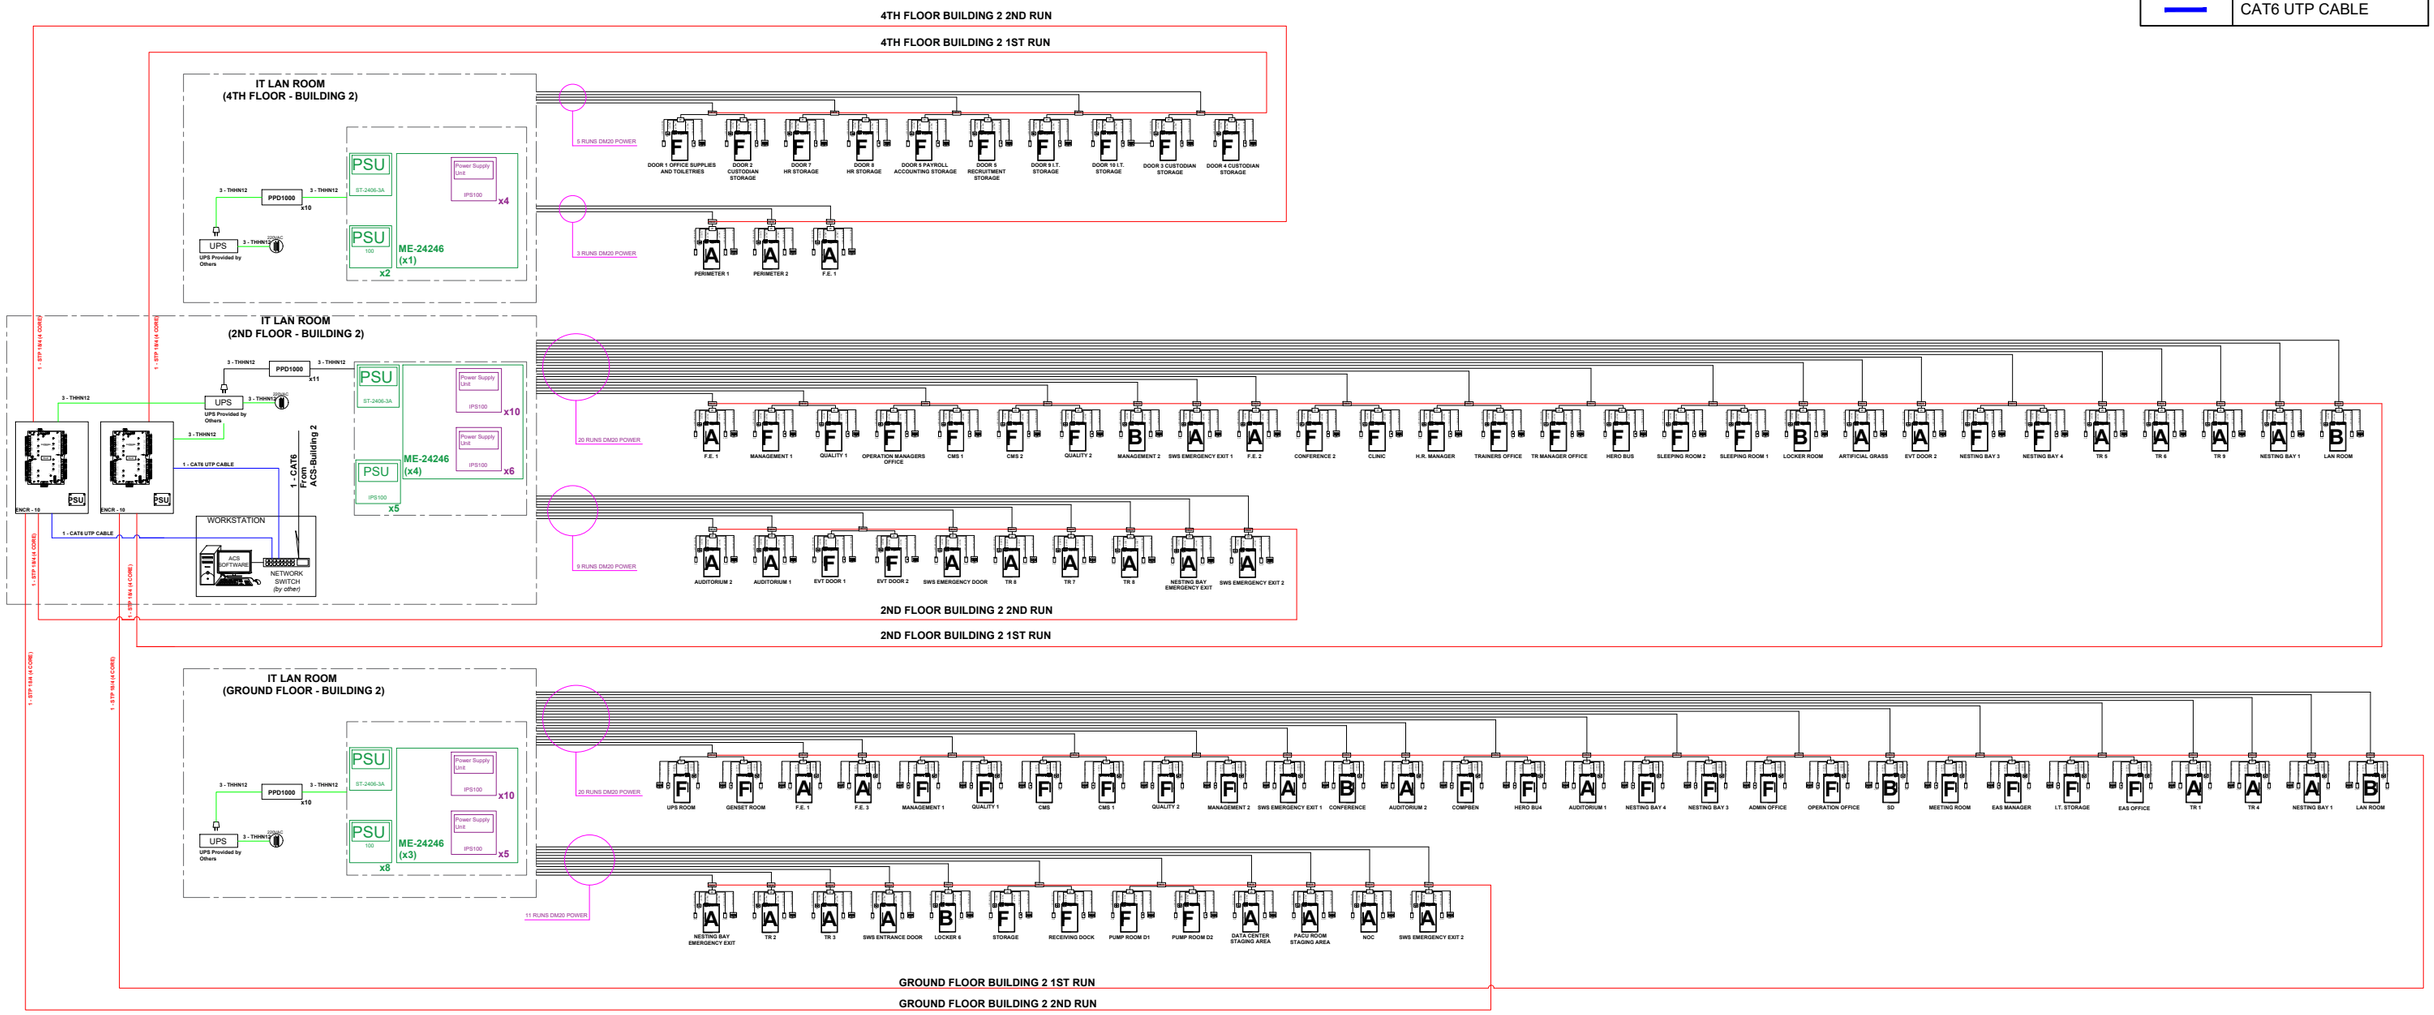

1 ASBUILT
PANASIATIC BUILDING 2

	DESIGNED AND SUBMIITED:	APPROVED BY:	PROJECT OWNER:		PROJECT & LOCATION:	SHEET CONTENTS:	SET NO.:	SHEET NO.:
nexus technologies, inc.	Robinson TAgasa ROBINSON SB. TAGASA PROJECT MANAGER	DIONICIO RAMOS PANASIATIC MANAGER, ENGINEERING AND AUXILIARY SERVICES	MS. SIONY HIJARA-FERRARIS		PANASIATIC SOLUTIONS PANASIATIC CALL CENTER INC.	DOOR ACCESS SINGLE LINE DIAGRAM		5