SUMMARY	
BIOMETRIC	3
HID READER	44
PUSH EXIT BUTTON	26

LEGEND	
	BIOMETRIC
	HID READER
	PUSH EXIT BUTTON
	WOOD DOOR
	GLASS DOOR
	METAL DOOR
	SLIDING DOOR
	1" PVC PIPE
	3/4" PVC PIPE
	1/2" PVC PIPE
	MODULE (DM20)
	SQUARE BOX

1 ASBUILT
GROUND FLOOR BUILDING 1

nexus technologies, inc.

DESIGNED AND SUBMITTED BY:	APPROVE BY:	PROJECT OWNER:		PROJECT & LOCATION:	SHEET CONTENTS:	SET NO.:	SHEET NO.:
Robinson TAgasa **ROBINSON SB. TAGASA** PROJECT MANAGER	**DIONICIO RAMOS** PANASIATIC MANAGER, ENGINEERING AND AUXILIARY SERVICES	**MS. SIONY HIJARA-FERRARIS**		**PANASIATIC SOLUTIONS** **PANASIATIC CALL CENTER INC.**	**DOOR ACCESS AND BIOMETRIC FLOOR PLAN**		1

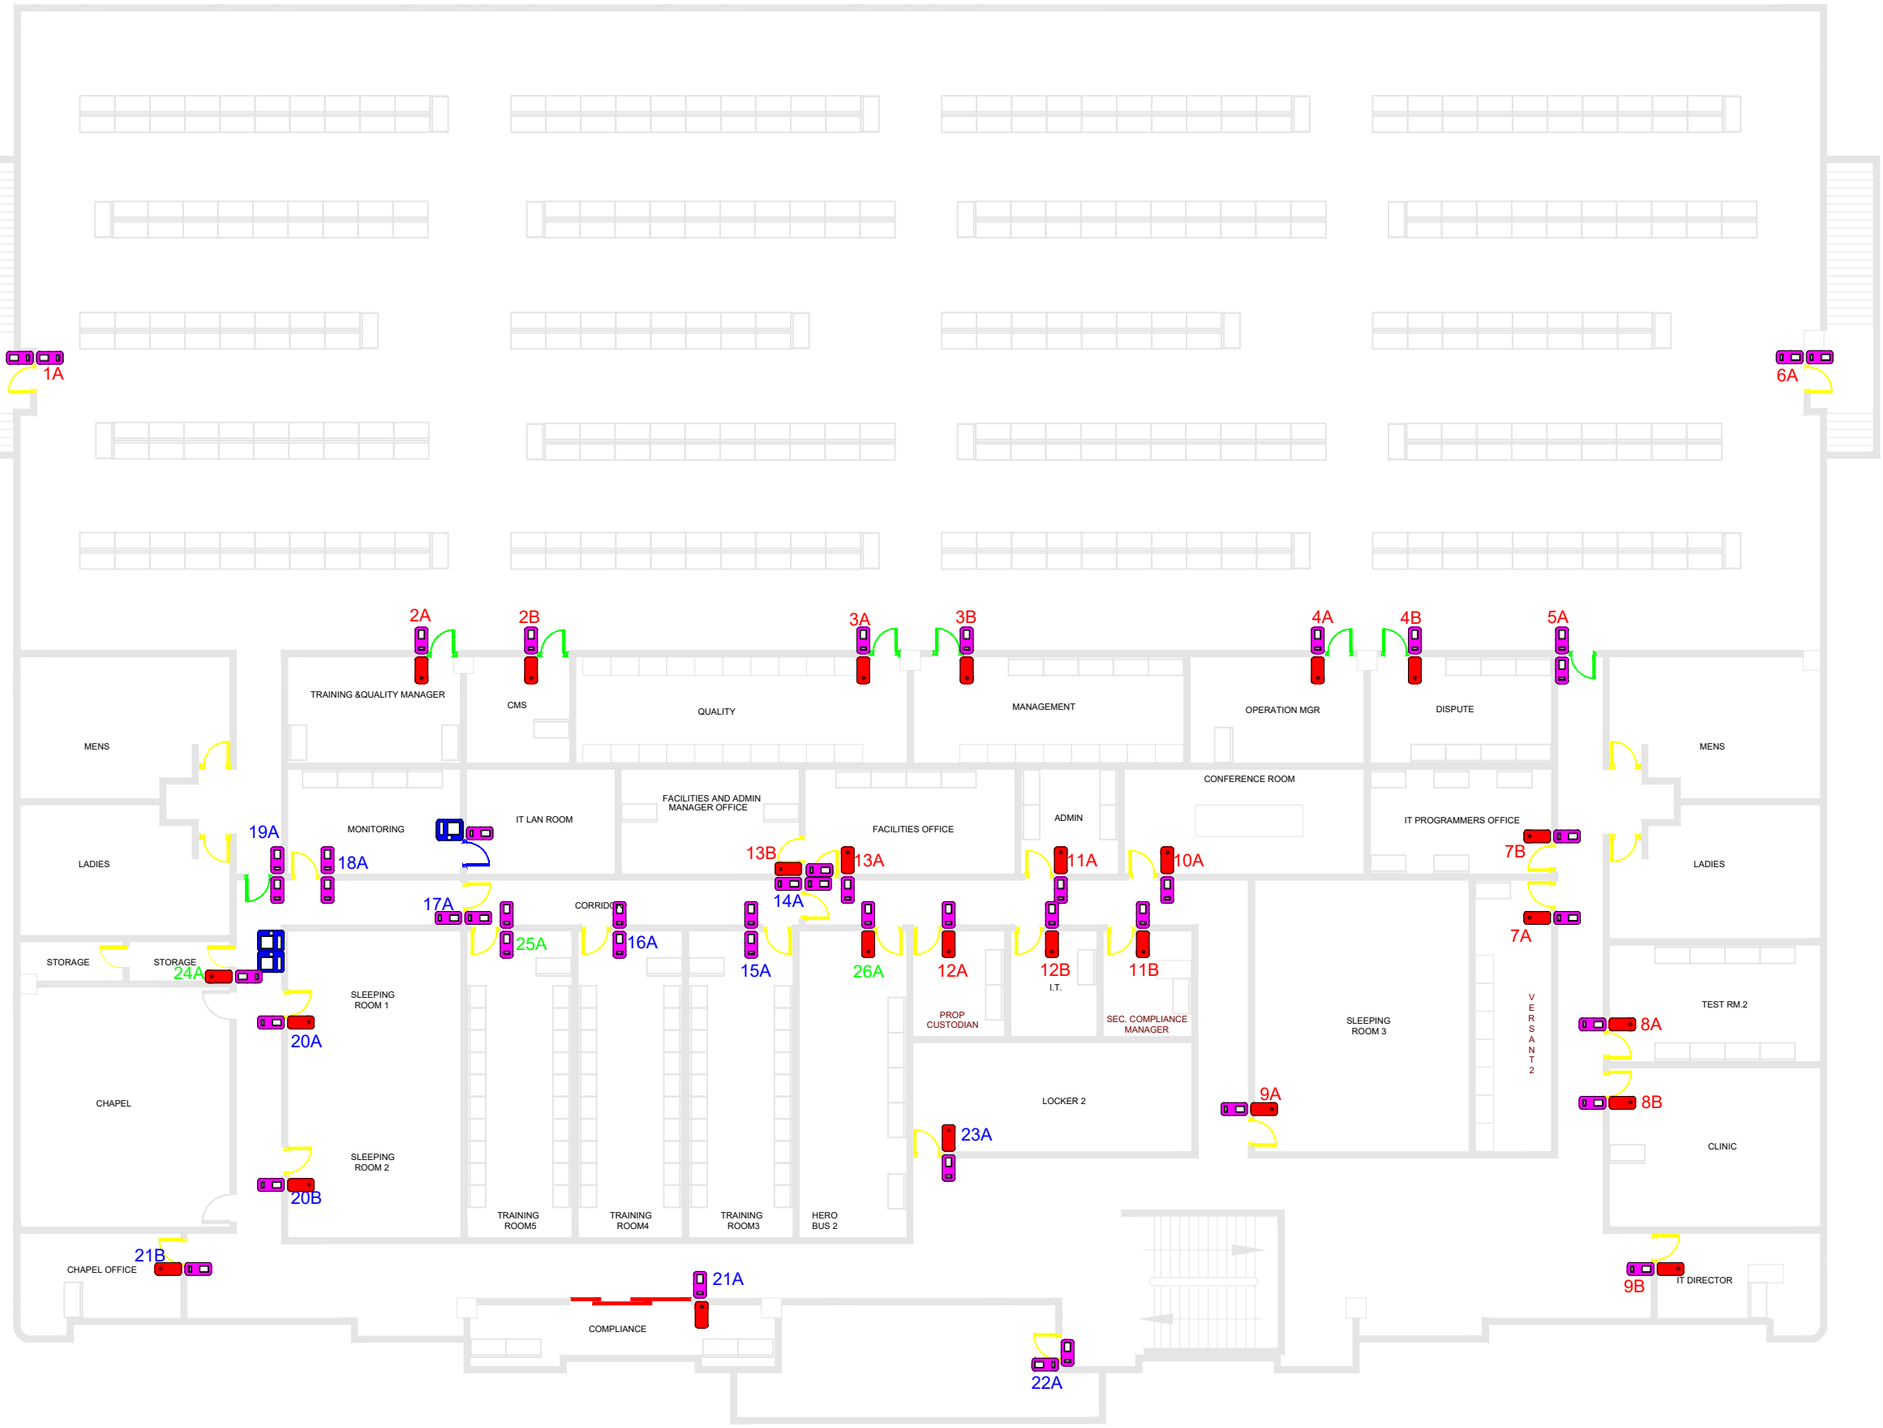

SUMMARY	
BIOMETRIC	3
HID READER	49
PUSH EXIT BUTTON	26

LEGEND	
	BIOMETRIC
	HID READER
	PUSH EXIT BUTTON
	WOOD DOOR
	GLASS DOOR
	METAL DOOR
	SLIDING DOOR
	1" PVC PIPE
	3/4" PVC PIPE
	1/2" PVC PIPE
	MODULE (DM20)
	SQUARE BOX

1

ASBUILT
2ND FLOOR BUILDING 1

nexus technologies, inc.

DESIGNED AND SUBMITTED BY:	APPROVE BY:	PROJECT OWNER:		PROJECT & LOCATION:	SHEET CONTENTS:	SET NO.:	SHEET NO.:
Robinson TAgasa **ROBINSON SB. TAGASA** PROJECT MANAGER	**DIONICIO RAMOS** PANASIATIC MANAGER, ENGINEERING AND AUXILIARY SERVICES	**MS. SIONY HIJARA-FERRARIS**		**PANASIATIC SOLUTIONS** **PANASIATIC CALL CENTER INC.**	**DOOR ACCESS AND BIOMETRIC FLOOR PLAN**		2

SUMMARY	
BIOMETRIC	3
HID READER	45
PUSH EXIT BUTTON	21

LEGEND	
	BIOMETRIC
	HID READER
	PUSH EXIT BUTTON
	WOOD DOOR
	GLASS DOOR
	METAL DOOR
	SLIDING DOOR
	1" PVC PIPE
	3/4" PVC PIPE
	1/2" PVC PIPE
	MODULE (DM20)
	SQUARE BOX

1

ASBUILT
3RD FLOOR BUILDING 1

	DESIGNED AND SUBMITTED BY:	APPROVE BY:	PROJECT OWNER:		PROJECT & LOCATION:	SHEET CONTENTS:	SET NO.:	SHEET NO.:
nexus technologies, inc.	Robinson TAgasa ROBINSON SB. TAGASA PROJECT MANAGER	DIONICIO RAMOS PANASIATIC MANAGER, ENGINEERING AND AUXILIARY SERVICES	MS. SIONY HIJARA-FERRARIS		PANASIATIC SOLUTIONS PANASIATIC CALL CENTER INC.	DOOR ACCESS AND BIOMETRIC FLOOR PLAN		3

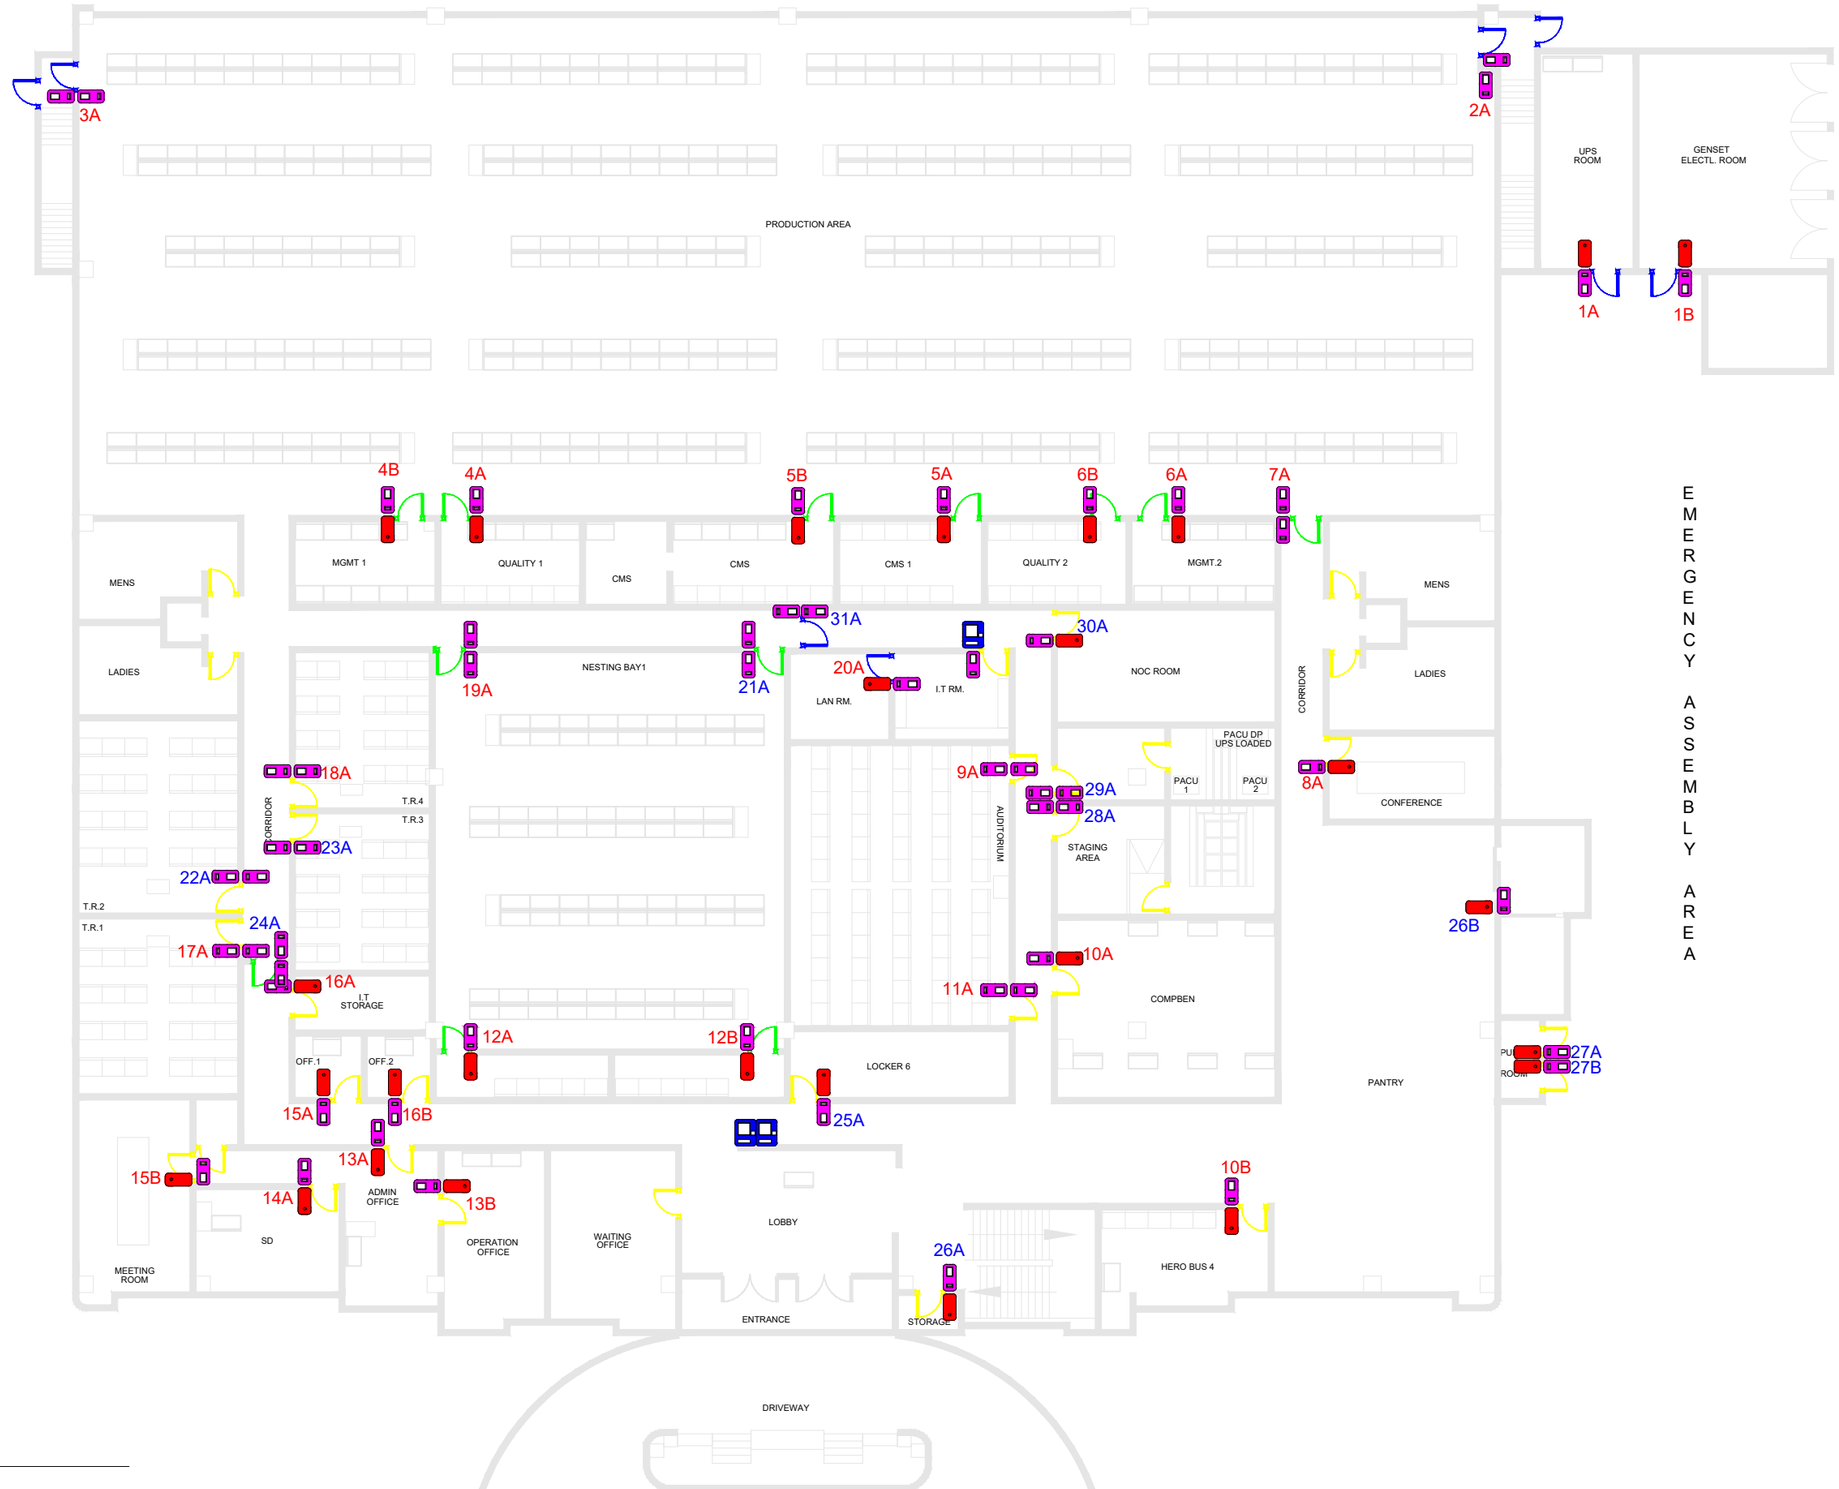

SUMMARY	
BIOMETRIC	3
HID READER	58
PUSH EXIT BUTTON	27

LEGEND	
	BIOMETRIC
	HID READER
	PUSH EXIT BUTTON
	WOOD DOOR
	GLASS DOOR
	METAL DOOR
	SLIDING DOOR
	1" PVC PIPE
	3/4" PVC PIPE
	1/2" PVC PIPE
	MODULE (DM20)
	SQUARE BOX

1 ASBUILT
GROUND FLOOR BUILDING 2

nexus technologies, inc.

DESIGNED AND SUBMITTED BY:	APPROVE BY:	PROJECT OWNER:		PROJECT & LOCATION:	SHEET CONTENTS:	SET NO.:	SHEET NO.:
Robinson TAgasa ROBINSON SB. TAGASA PROJECT MANAGER	DIONICIO RAMOS PANASIATIC MANAGER, ENGINEERING AND AUXILIARY SERVICES	MS. SIONY HIJARA-FERRARIS		PANASIATIC SOLUTIONS PANASIATIC CALL CENTER INC.	DOOR ACCESS AND BIOMETRIC FLOOR PLAN		4

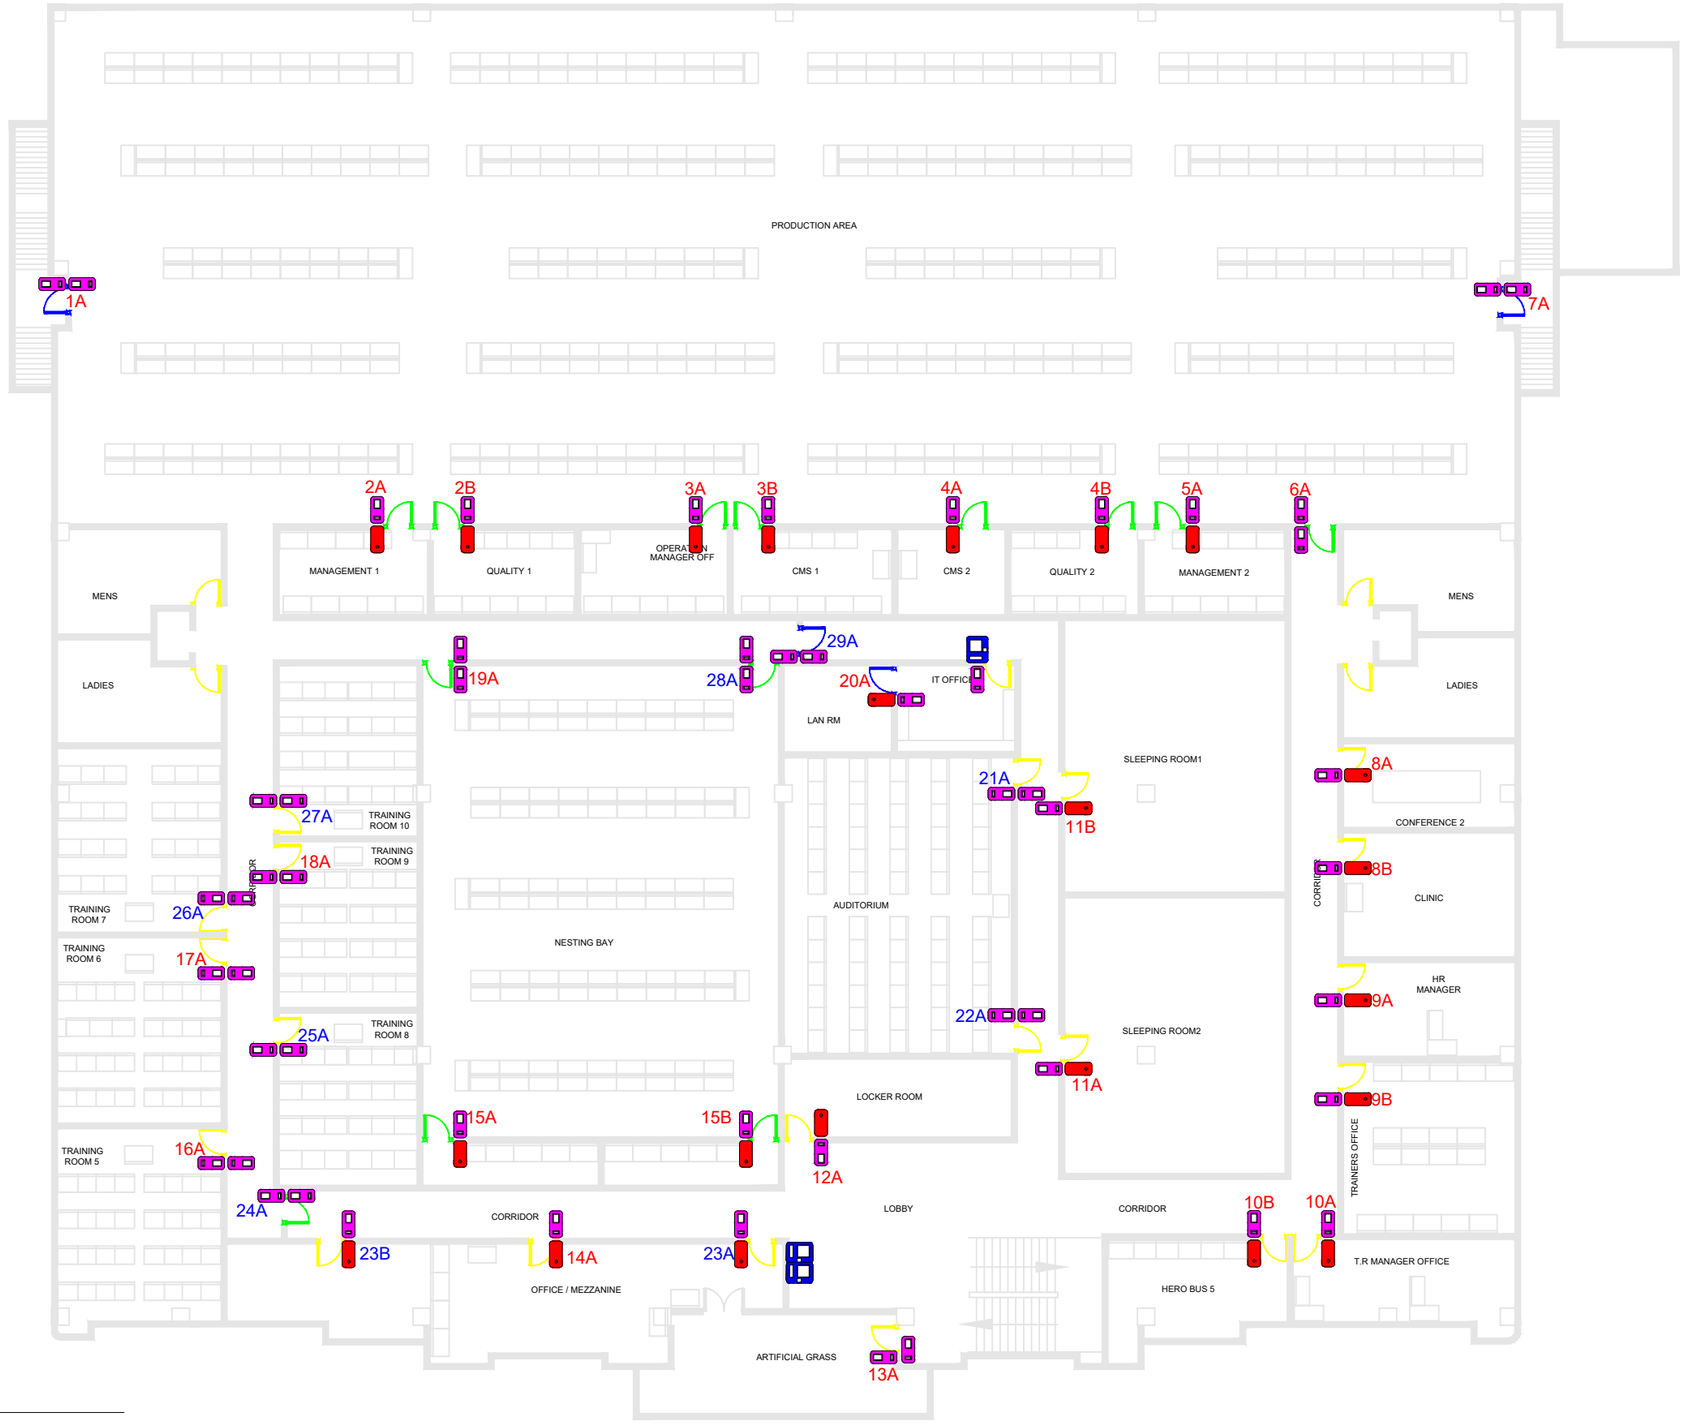

SUMMARY	
BIOMETRIC	3
HID READER	55
PUSH EXIT BUTTON	22

LEGEND	
	BIOMETRIC
	HID READER
	PUSH EXIT BUTTON
	WOOD DOOR
	GLASS DOOR
	METAL DOOR
	SLIDING DOOR
	1" PVC PIPE
	3/4" PVC PIPE
	1/2" PVC PIPE
	MODULE (DM20)
	SQUARE BOX

1 ASBUILT
2ND FLOOR BUILDING 2

	DESIGNED AND SUBMITTED BY:	APPROVE BY:	PROJECT OWNER:		PROJECT & LOCATION:	SHEET CONTENTS:	SET NO.:	SHEET NO.:
nexus technologies, inc.	Robinson TAgasa **ROBINSON SB. TAGASA** PROJECT MANAGER	**DIONICIO RAMOS** PANASIATIC MANAGER, ENGINEERING AND AUXILIARY SERVICES	**MS. SIONY HIJARA-FERRARIS**		**PANASIATIC SOLUTIONS** **PANASIATIC CALL CENTER INC.**	**DOOR ACCESS AND BIOMETRIC FLOOR PLAN**		5

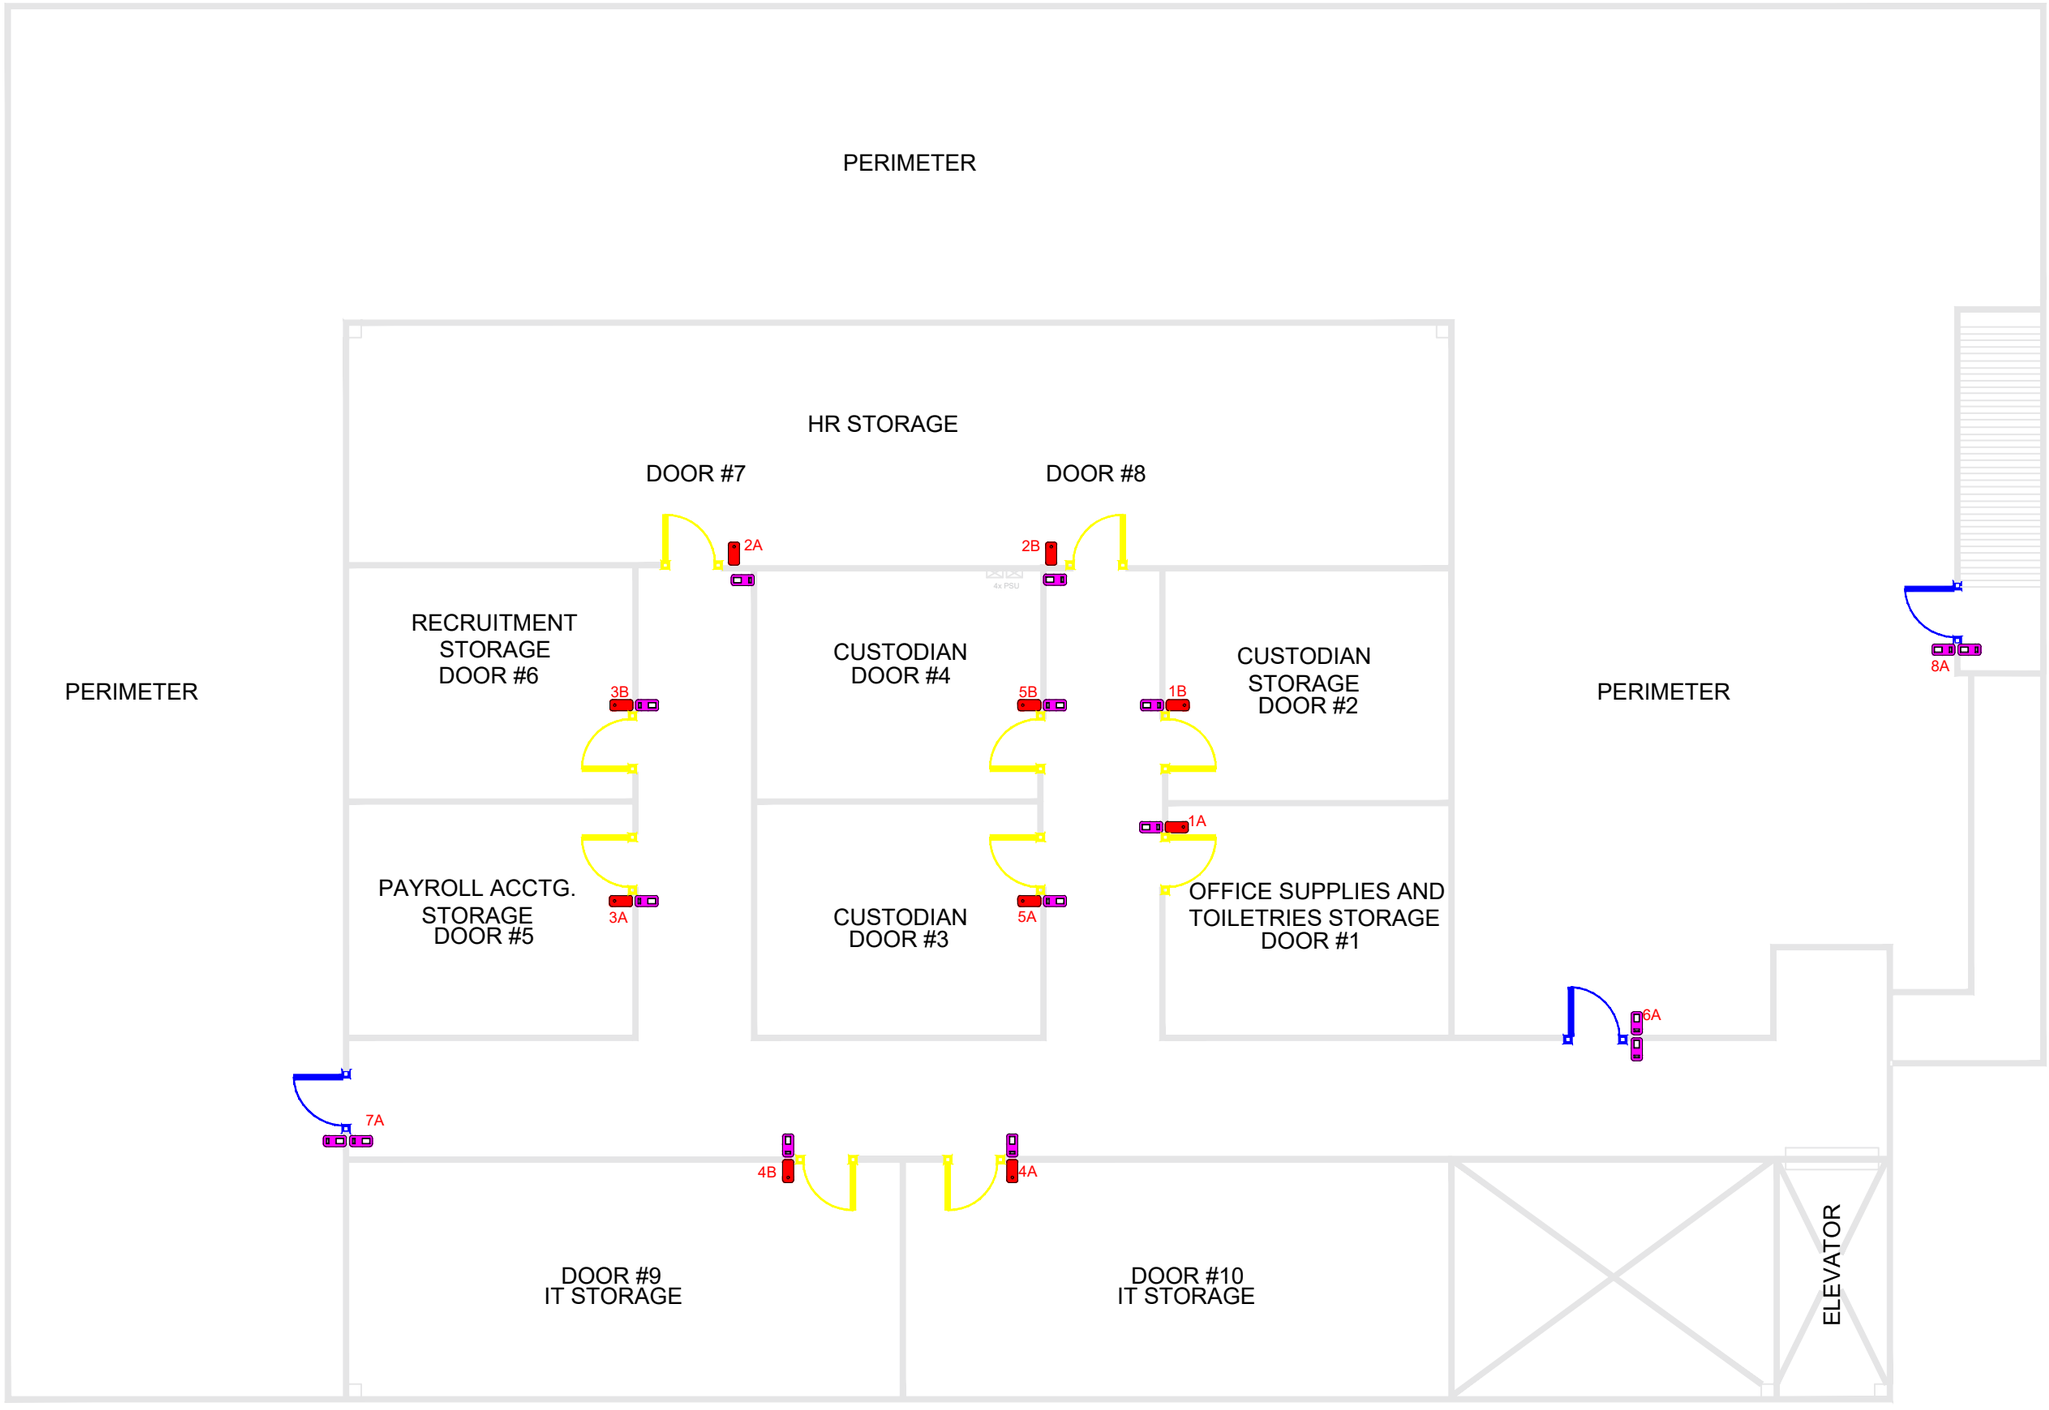

SUMMARY	
BIOMETRIC	
HID READER	16
PUSH EXIT BUTTON	10

LEGEND	
	BIOMETRIC
	HID READER
	PUSH EXIT BUTTON
	WOOD DOOR
	GLASS DOOR
	METAL DOOR
	SLIDING DOOR
	1" PVC PIPE
	3/4" PVC PIPE
	1/2" PVC PIPE
	MODULE (DM20)
	SQUARE BOX

1

ASBUILT
4TH FLOOR BUILDING 2

nexus technologies, inc.

DESIGNED AND SUBMITTED BY:	APPROVE BY:	PROJECT OWNER:		PROJECT & LOCATION:	SHEET CONTENTS:	SET NO.:	SHEET NO.:
Robinson TAgasa **ROBINSON SB. TAGASA** PROJECT MANAGER	**DIONICIO RAMOS** PANASIATIC MANAGER, ENGINEERING AND AUXILIARY SERVICES	**MS. SIONY HIJARA-FERRARIS**		**PANASIATIC SOLUTIONS** **PANASIATIC CALL CENTER INC.**	**DOOR ACCESS AND BIOMETRIC FLOOR PLAN**		6